


INFORMATION FROM SITE SURVEY	
1. OCCUPANCY	= G1 - OFFICE
2. FLOOR AREA	= 657 m²
3. EXISTING SIGNAGE EQUIPMENT AS INSTALLED ON SITE:	
4.1. FIRE EXTINGUISHERS	= 3
4.2. FIRE HOSE REEL	= 1




- MAJOR LIST OF NON- CONFORMANCES
1. NO HYDRANT IN BUILDING.
  2. PARTITION LAYOUT DOES NOT MATCH DRAWINGS.
  3. TURN STYLE TO RELEASE IN FIRE CONDITION.
  4. NO BREAK GLASS UNIT LOCATION SIGNS.
  5. NO DETECTION TO STORE ROOM.
  6. DIRECTIONAL SIGNAGE NEED ATTENTION FIRE EQUIPMENT & ESCAPE ROUTE.
  7. NO EXIT, KEEP CLEAR SIGN.
  8. DETECTION TO BE INTERFACED WITH THE FOLLOWING:  
5.1 AC SHUTDOWN.
  9. ROOF PLANET ROOM NEEDS FIRE PROTECTION EQUIPMENT.

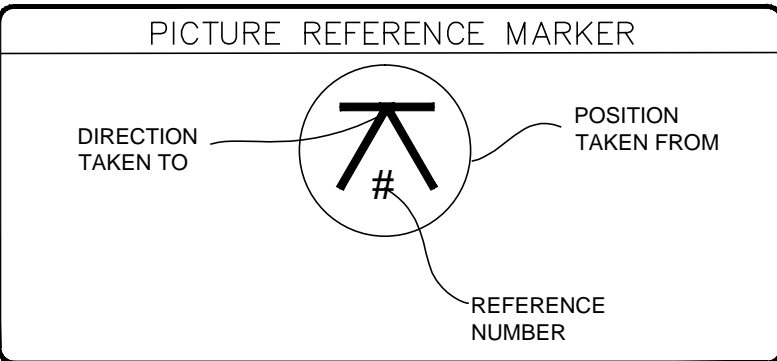

ISSUE DATE:	REVISION:
2021-05-25	A
X FOR INFORMATION	
FOR APPROVAL	
FOR TENDER	
FOR CONSTRUCTION	
AS-BUILT	

REVISIONS					
No	Date	Description	Rev By	Ckd By	
A	25/05/2021	ISSUED FOR INFORMATION	S.M	H.R	

		09 Plantanus Street Kuilsriver 7580	
PROJECT		LAHAE LA SARS - BLOCK B	
DWG TITLE		BROOKLYN	
DWG NUMBER		21B09-F-502-02	
DESIGNED BY		B. NOFEMELE	
CHECKED BY		H.D ROUX	
APPROVED BY		H.D ROUX	
SCALE		1:100 @ A1	
ECSA NUMBER		201070151	
ECSA NUMBER		201070151	
COPYRIGHT AND RIGHT OF REPRODUCTION OF THIS DRAWING OR ANY PORTION THEREOF IS RESERVED BY THE ENGINEERS			

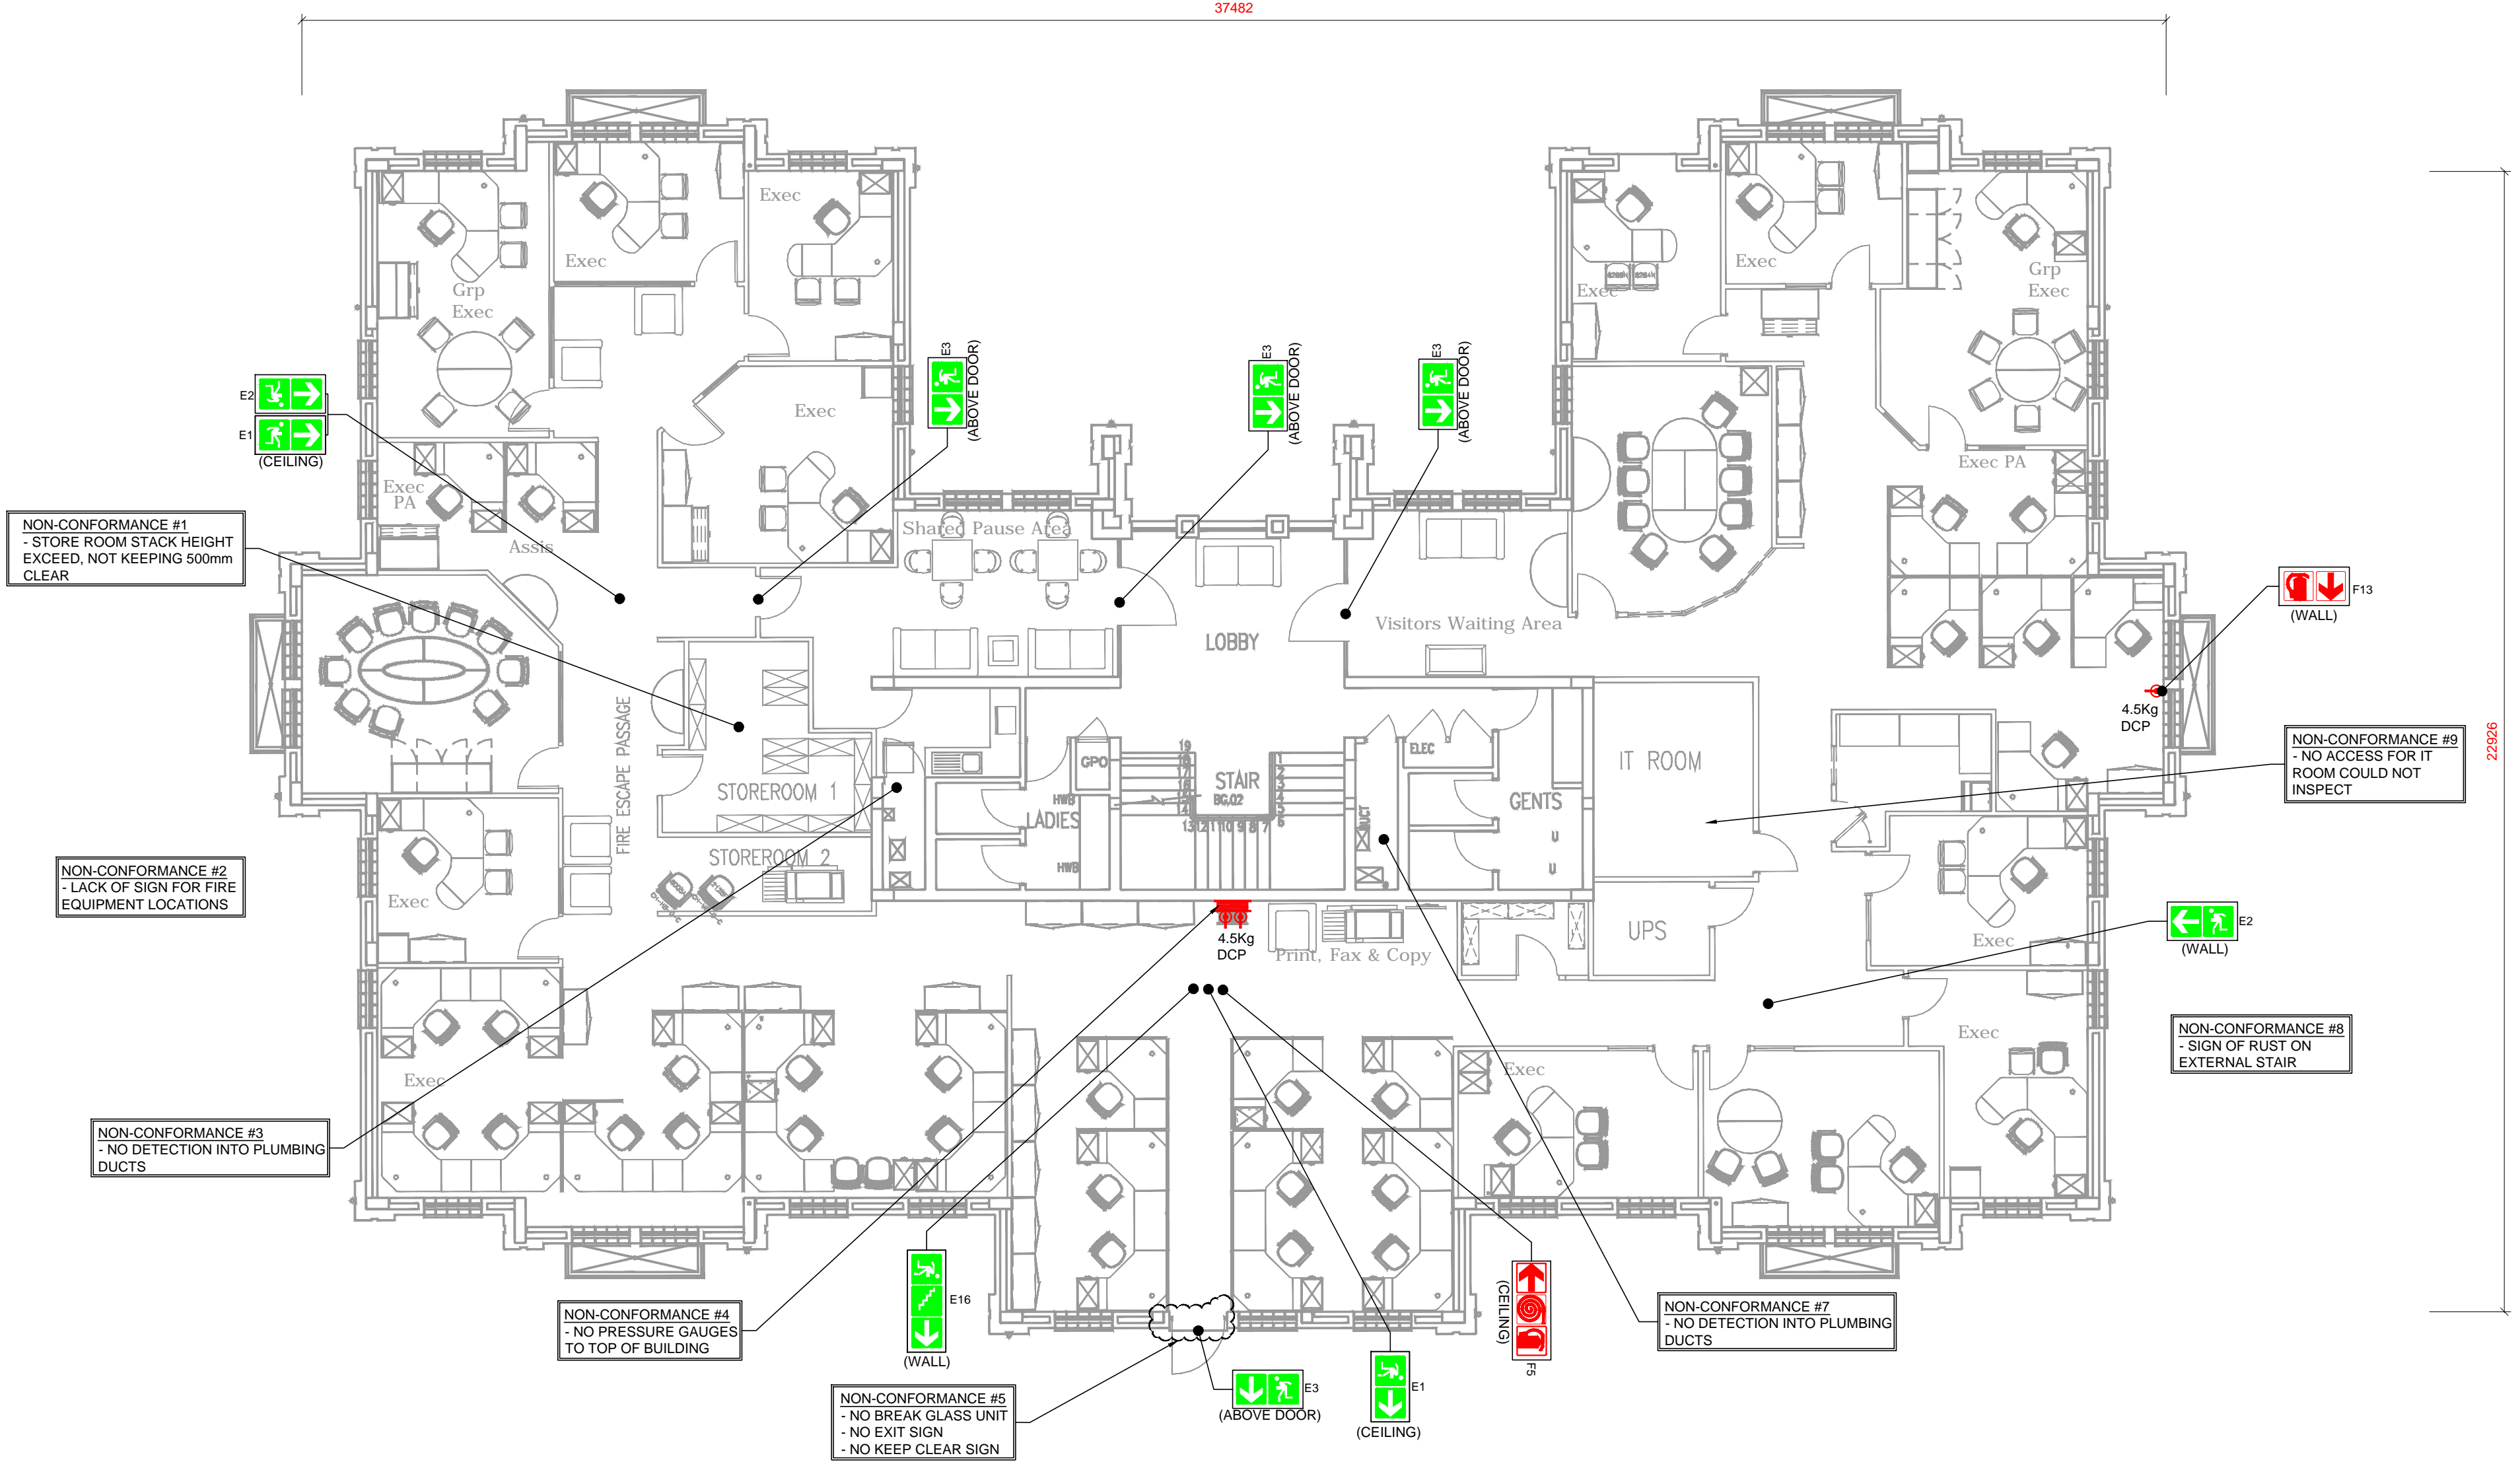

FIRST STOREY - EXISTING FIRE SERVICES LAYOUT (Scale 1:100)